
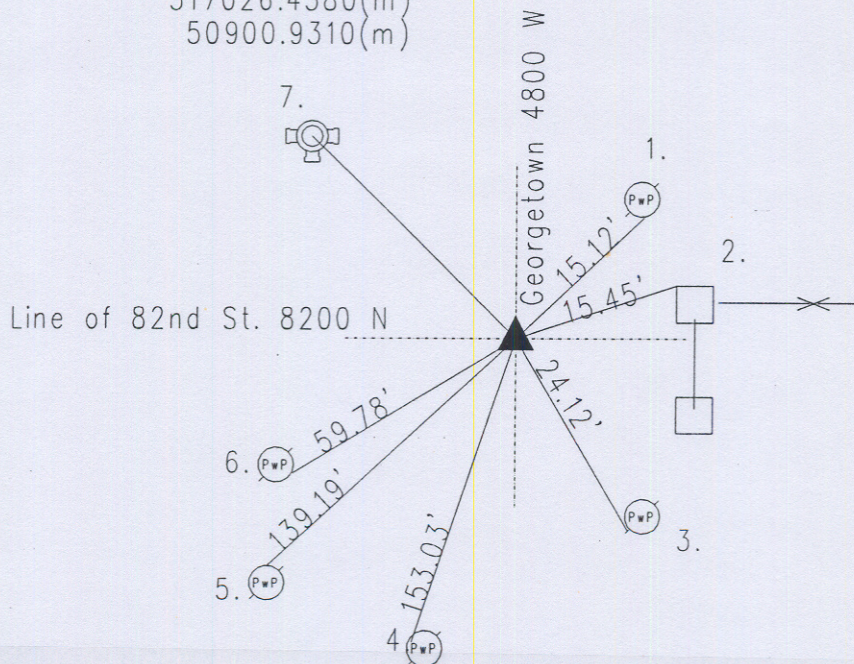


OFFICE OF THE MARION COUNTY SURVEYOR
SECTION RECORD CORNER
SECTION 24 TOWNSHIP 17 RANGE 2
DATE: 4-21-06
PARTY CHIEF: Wilcoxen
CREW: _____
TYPE OF MARKER: Harrison
METHOD OF ESTABLISHMENT: County: 4-11-02
IN. S.P.C. E ZONE NAD '83
NAME: 17022406
N: 517026.4580(m)
E: 50900.9310(m)

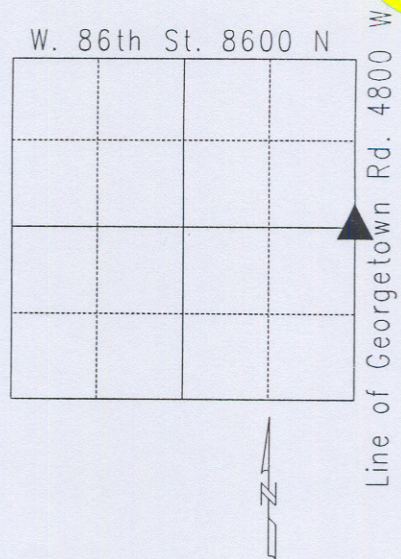

17022406 E Q corner

CORNER HISTORY: Corner originally set as a post in 1821 by Wm. B. Laughlin with witness: 5" hornbeam N 88 W 15 links; 10" beech S 68 E 16 links per Marion County Atlas pg. 4. A survey in 1853 by D. B. Hosbrook showed distances only. Old tie card 4-25-1945 called a concrete monument set 6" down. Reference dated 8-7-1959 by Hankins called a steel pin over concrete marker. Reference dated 8-9-73 by McLand called a PK nail. Reference dated 10-19-1981 called dug. The PK nail was at the surface over the concrete marker. Reference dated 6-23-88 by Gries called as a PK nail. Reference dated 4-7-97 by Wilcoxen called a PK nail. Reference dated 4-19-06 by Wilcoxen called found 2 PK nails side by side 4" down. Found $\frac{3}{4}$ " steel guard pin 12" down. Found cut concrete stone 18" down. Set Harrison on top of stone.

REF.	DISTANCE	DESCRIPTION
1.	15.12'	PK nail S PwP#62-227 A 6"up
2.	15.45'	Road nail N corner fence post 7"up
3.	24.12'	Mag nail w/bw SW PwP#358-227 A 4"up
4.	153.03'	Mag nail w/bw NW PwP#165-227 A 24"up
5.	139.19'	Mag nail NW PwP#364-227 A 36"up
6.	59.78'	PK nail SF PwP#102-227 A 5"up
7.	81.18'	Top nut of fire hydrant